


01 UNIT 24 SECTION A - A
1226 1:50

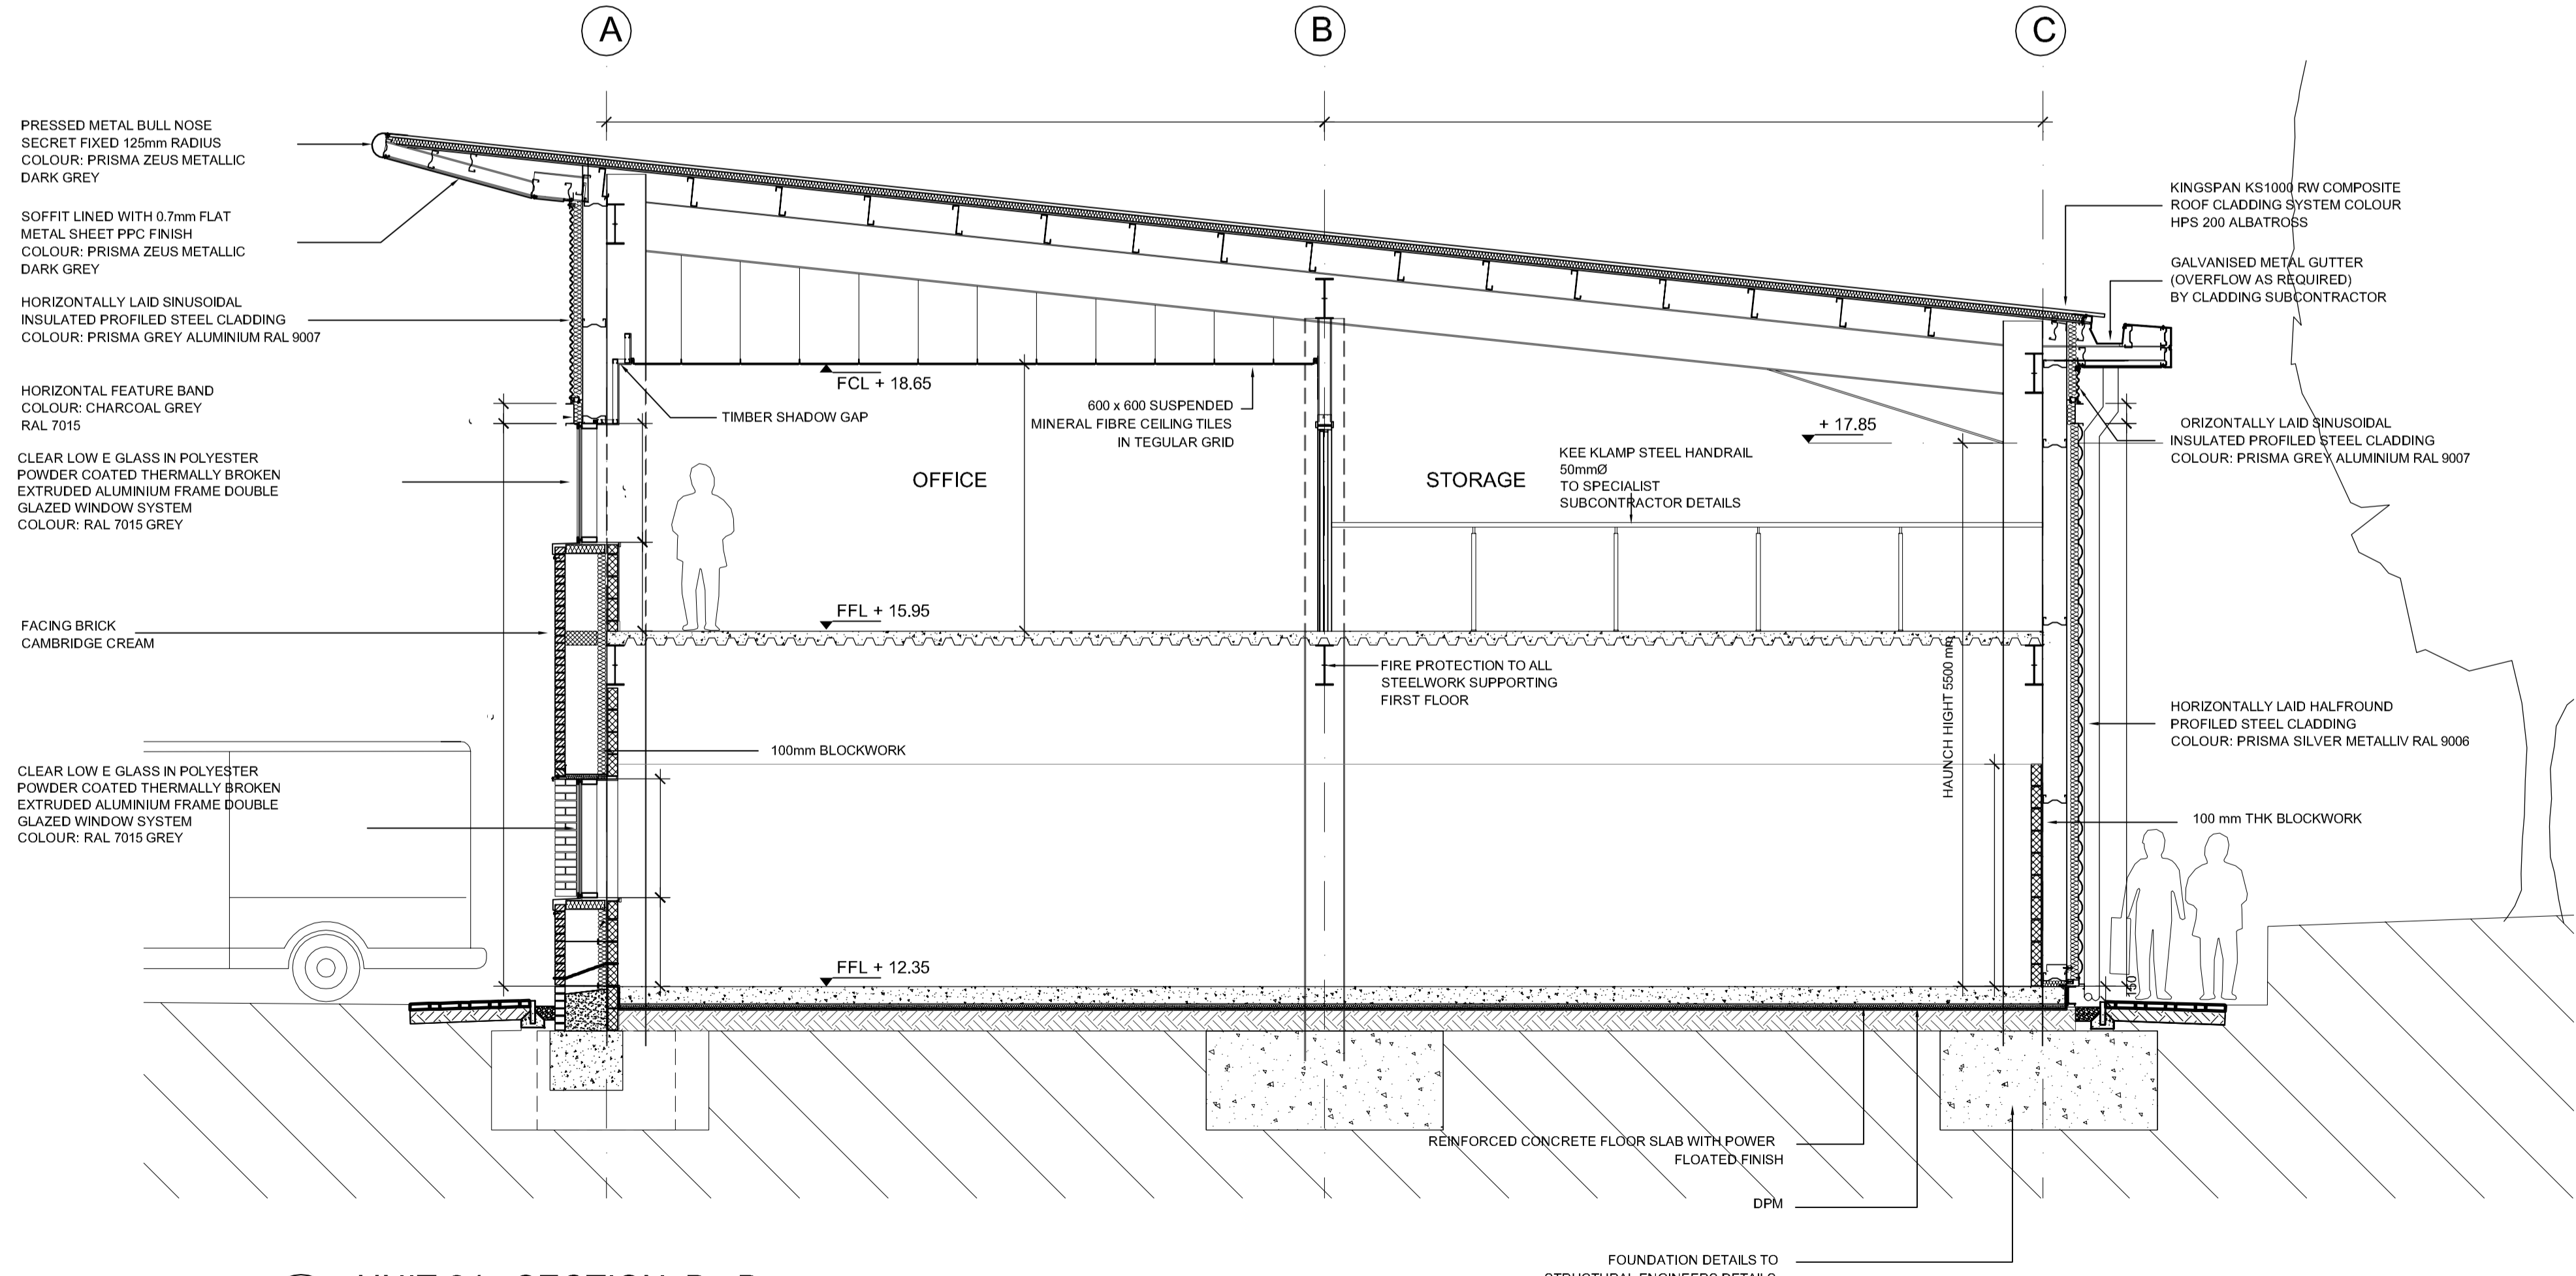

02 UNIT 24 SECTION B - B
1226 1:50


NOTES:
 SUBJECT TO STATUTORY CONSENTS
 SUBJECT TO SURVEY
 BASED ON OS MAP REPRODUCED BY PERMISSION OF CONTROLLER OF HM STATIONARY OFFICE (c) CROWN COPYRIGHT
 COPYRIGHT RESERVED
 DO NOT SCALE THIS DRAWING
 DO NOT USE ELECTRONIC VERSIONS OF THIS DRAWING TO DETERMINE DIMENSIONS UNLESS SPECIFICALLY AUTHORISED BY MICHAEL SPARKS ASSOCIATES
 IF USING AN ELECTRONIC VERSION OF THIS DRAWING FIGURED DIMENSIONS TAKE PRECEDENCE AND NOTIFY MICHAEL SPARKS ASSOCIATES OF ANY DISCREPANCIES

ENSURE SEALING OF ALL JUNCTIONS TO COMPLY WITH PART L

U-Values
 Roof: 0.25
 Floors: 0.25
 Walls: 0.35
 Glazing: 1.50

NOTE:
 ROOF AND WALL CLADDING TO BE DESIGNED BY SPECIALIST CONTRACTOR.
 CLADDING DETAILS TO BE READ IN CONJUNCTION WITH THE SPECIFICATION AND ALL RELEVANT BRITISH STANDARDS.
 INCLUDE VAPOUR BARRIER TAPE AROUND ALL OPENINGS AND JUNCTIONS.

ALL DIMENSIONS TO BE CHECKED ON SITE.
 STEEL COLUMN SIZES TO BE CONFIRMED AND TOLERANCES TO BE AGREED.

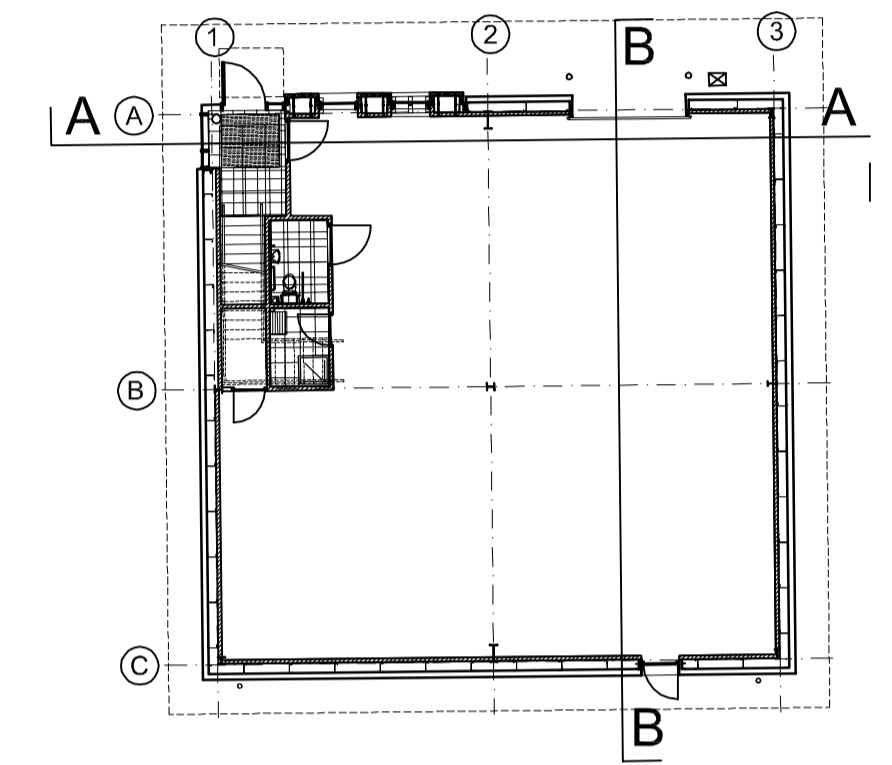

03 UNIT 24 GF PLAN
1226 1:200

AS BUILT

THIS "AS-BUILT" DRAWING IS BASED ON INFORMATION SUPPLIED TO MICHAEL SPARKS ASSOCIATES BY MC LAREN CONSTRUCTION AND INCORPORATES INSTRUCTIONS AND OTHER DESIGN INFORMATION GIVEN TO MC LAREN CONSTRUCTION DIRECTLY BY OTHERS

REV	DATE	NOTE	DRAW	CHK
A	30.03.2009	Refer to sub-contractors drawings for specialist details This supersedes drawing no: 2716/RE/386 rev.B	JH	NSC

MICHAEL SPARKS ASSOCIATES
 CHARTERED ARCHITECTS
 11 PLATO PLACE
 ST BONS ROAD
 LONDON SW6 4TU
 TELEPHONE 020 7736 6162
 FAX 020 7736 3896
 www.msa-architects.co.uk

FROGMORE

TITLE
CROSSWAYS, DARTFORD

DRAWING
SCHOONER PARK UNIT 24 SECTIONS

CLIENT
FROGMORE

DATE	SCALE	DRAWN
MARCH 2009	1:50 @ A1	JH

STATUS	CHECKED
AS BUILT	NSC

DRAWING NUMBER
2716 / AB / 1226 A