




01 UNIT 17 - GF CORE PLAN
1:50

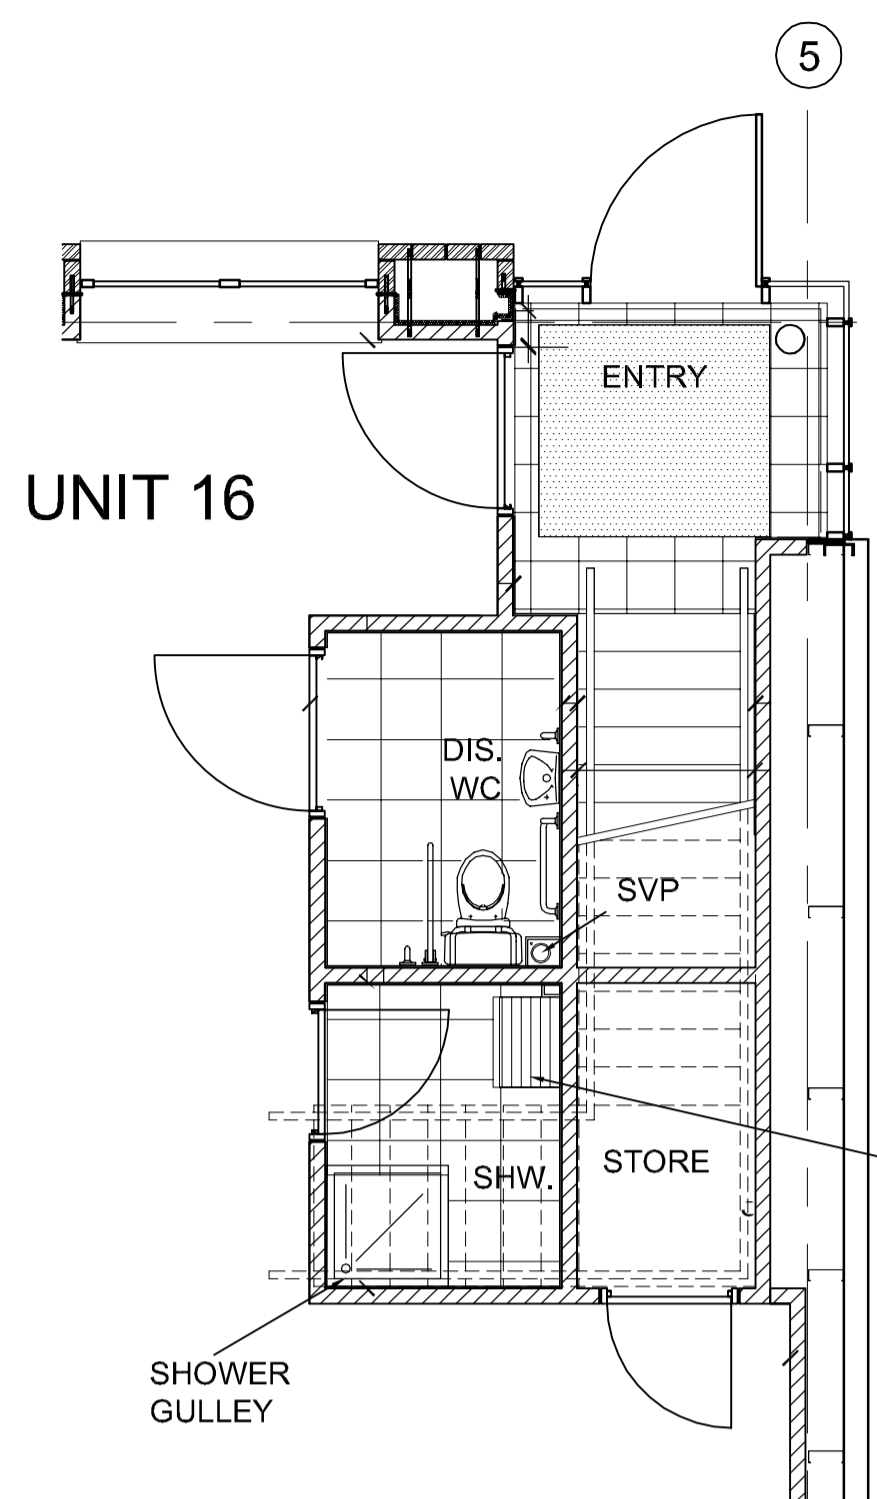


03 UNIT 16 - GF CORE PLAN
1:50

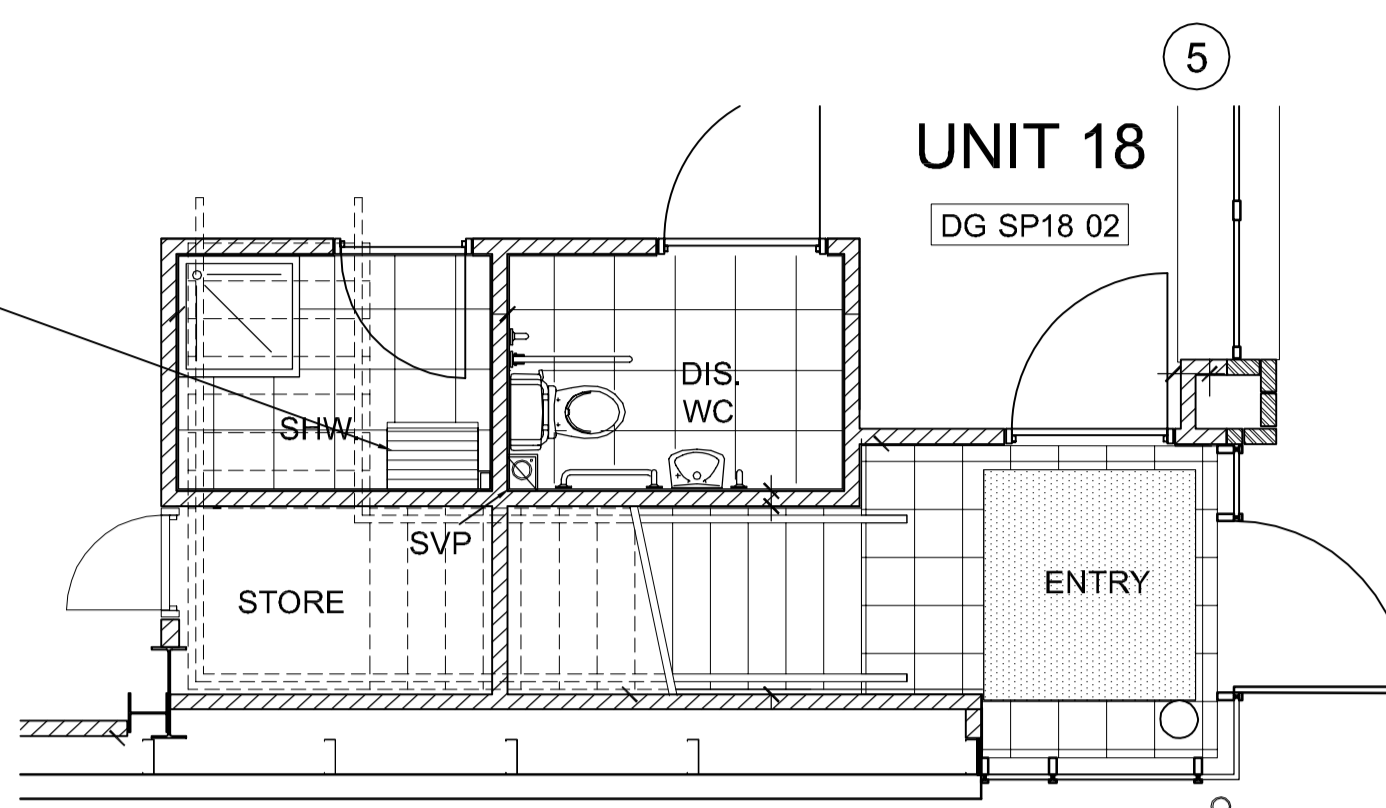


05 UNIT 18 - GF CORE PLAN
1:50

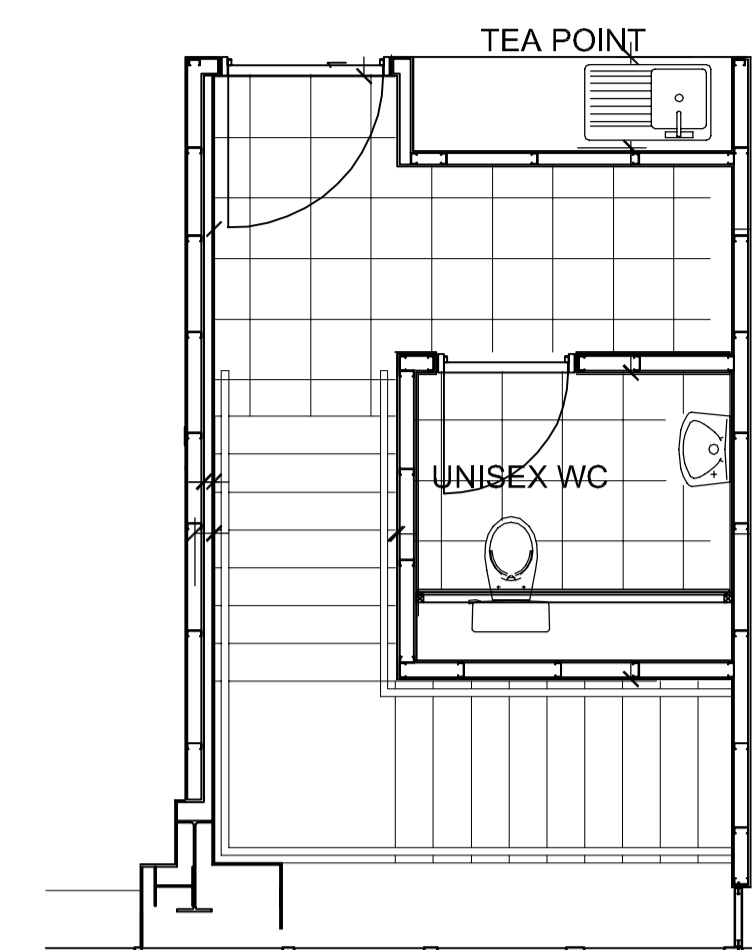


06 UNIT 18 - FF CORE PLAN
1:50

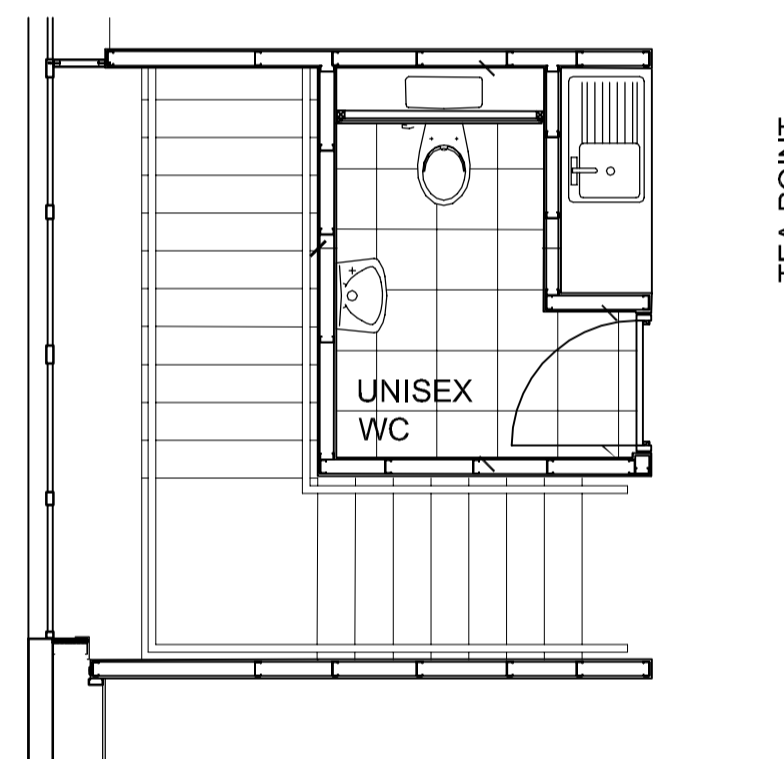


02 UNIT 17 - FF CORE PLAN
1:50

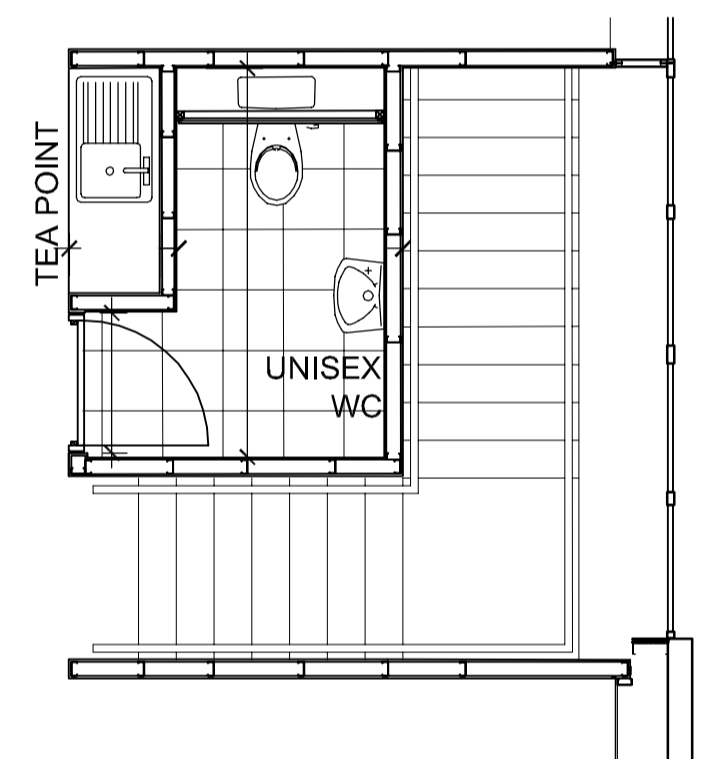


04 UNIT 16 - FF CORE PLAN
1:50

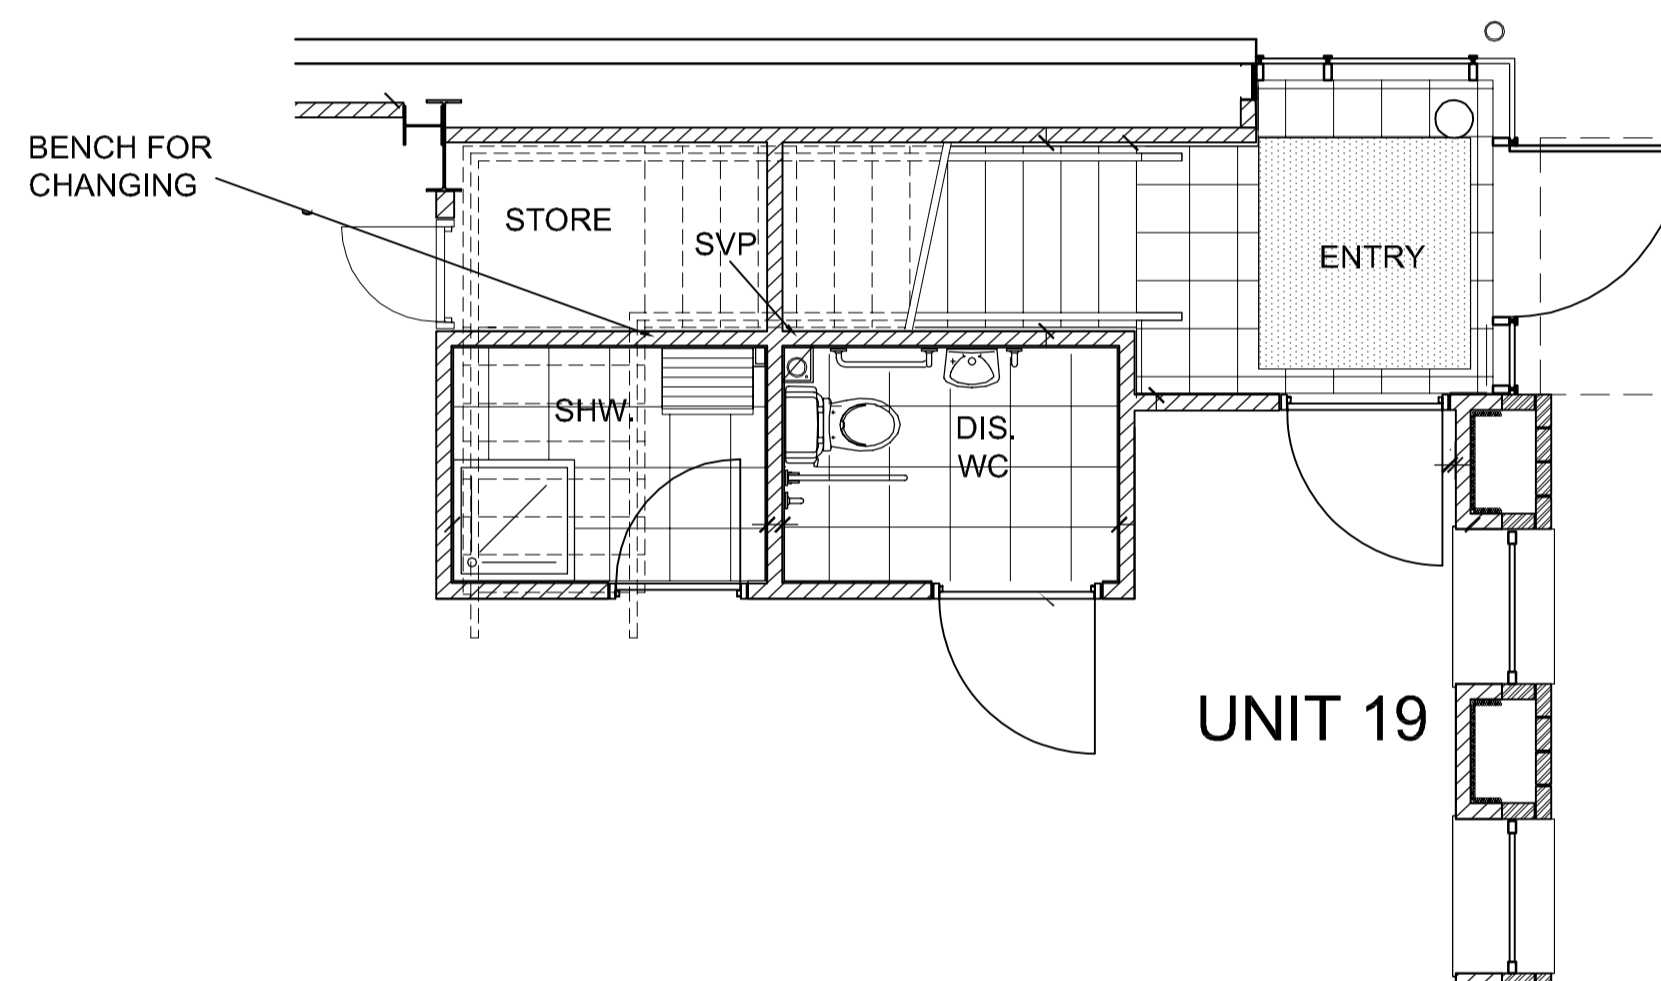


07 UNIT 19 - GF CORE PLAN
1:50

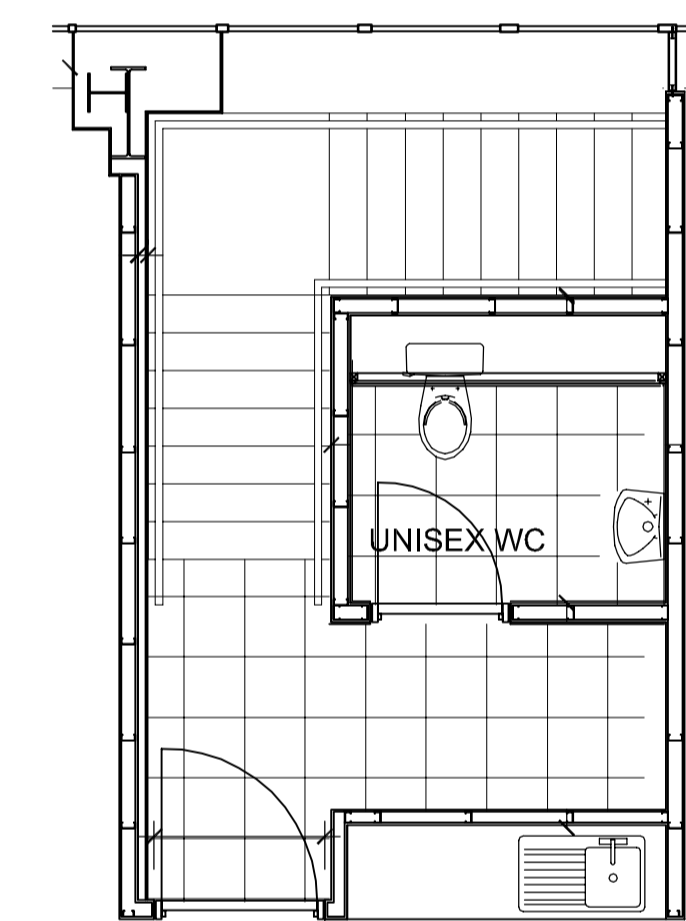


08 UNIT 19 - FF CORE PLAN
1:50

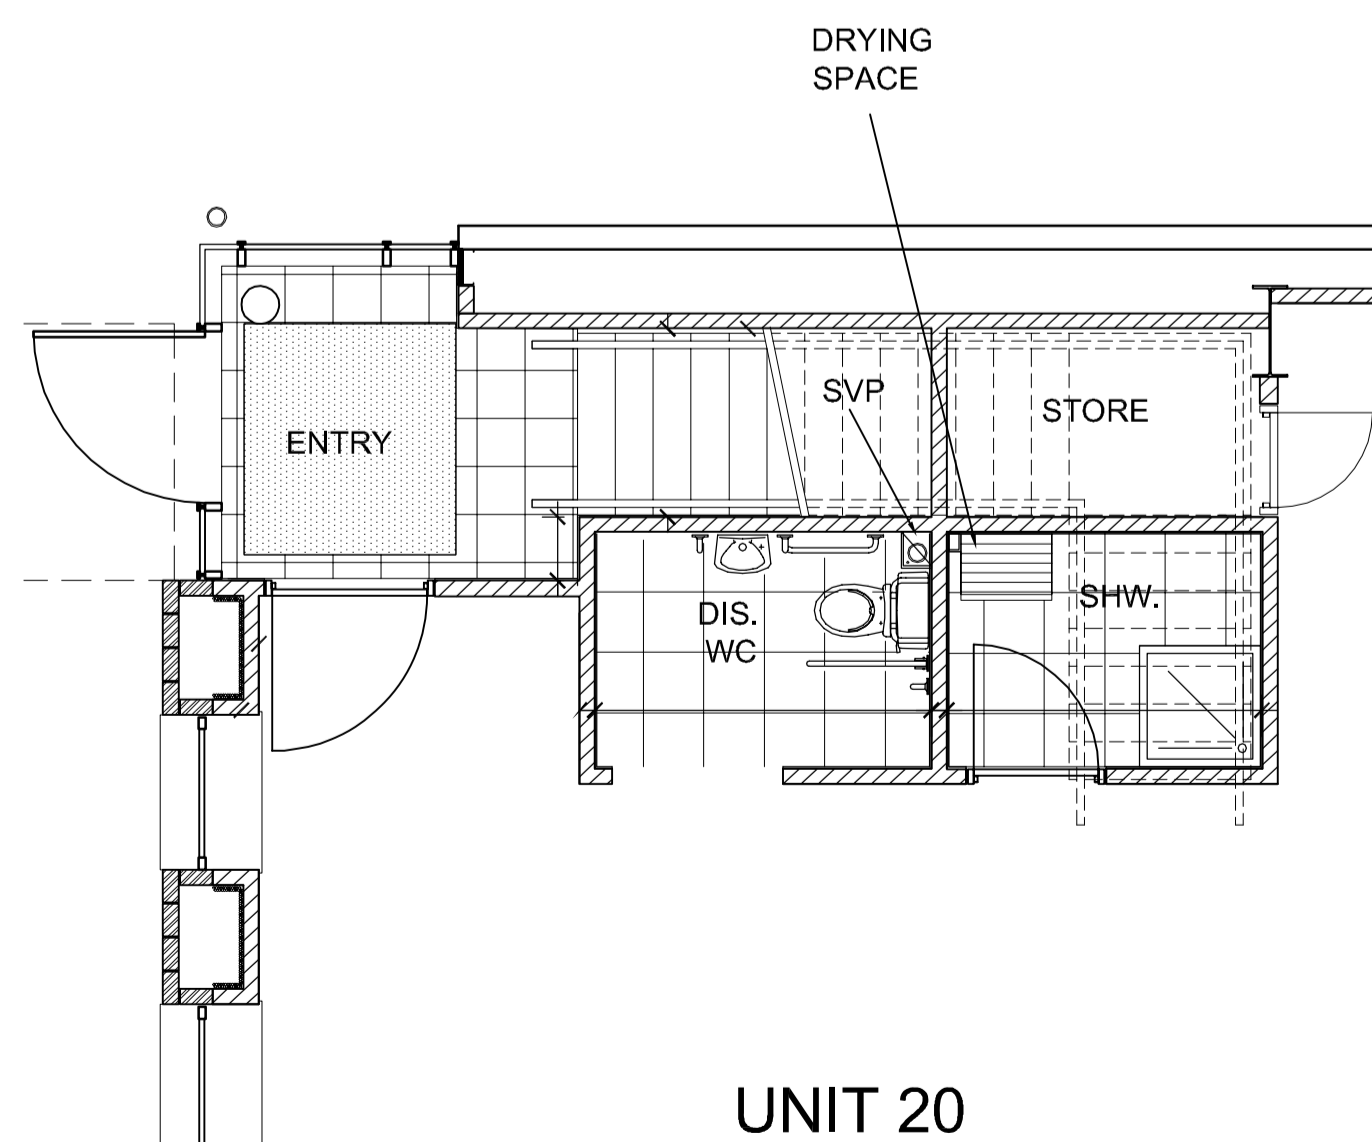


09 UNIT 20 - GF CORE PLAN
1:50

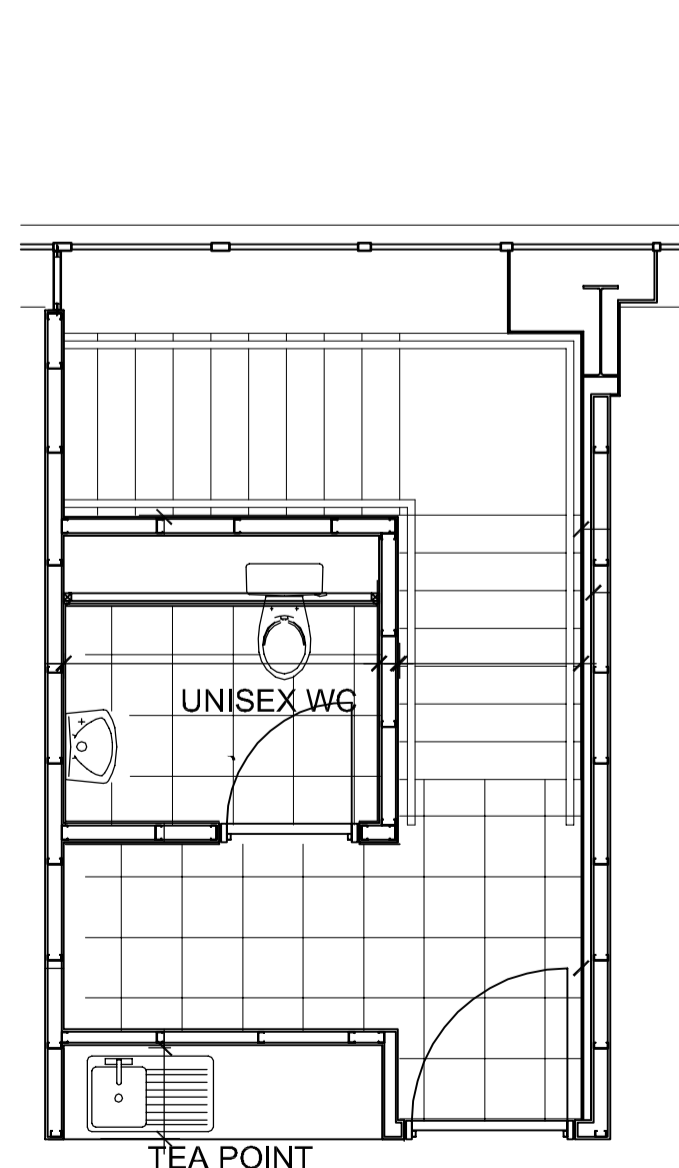

10 UNIT 20 - FF CORE PLAN
1:50

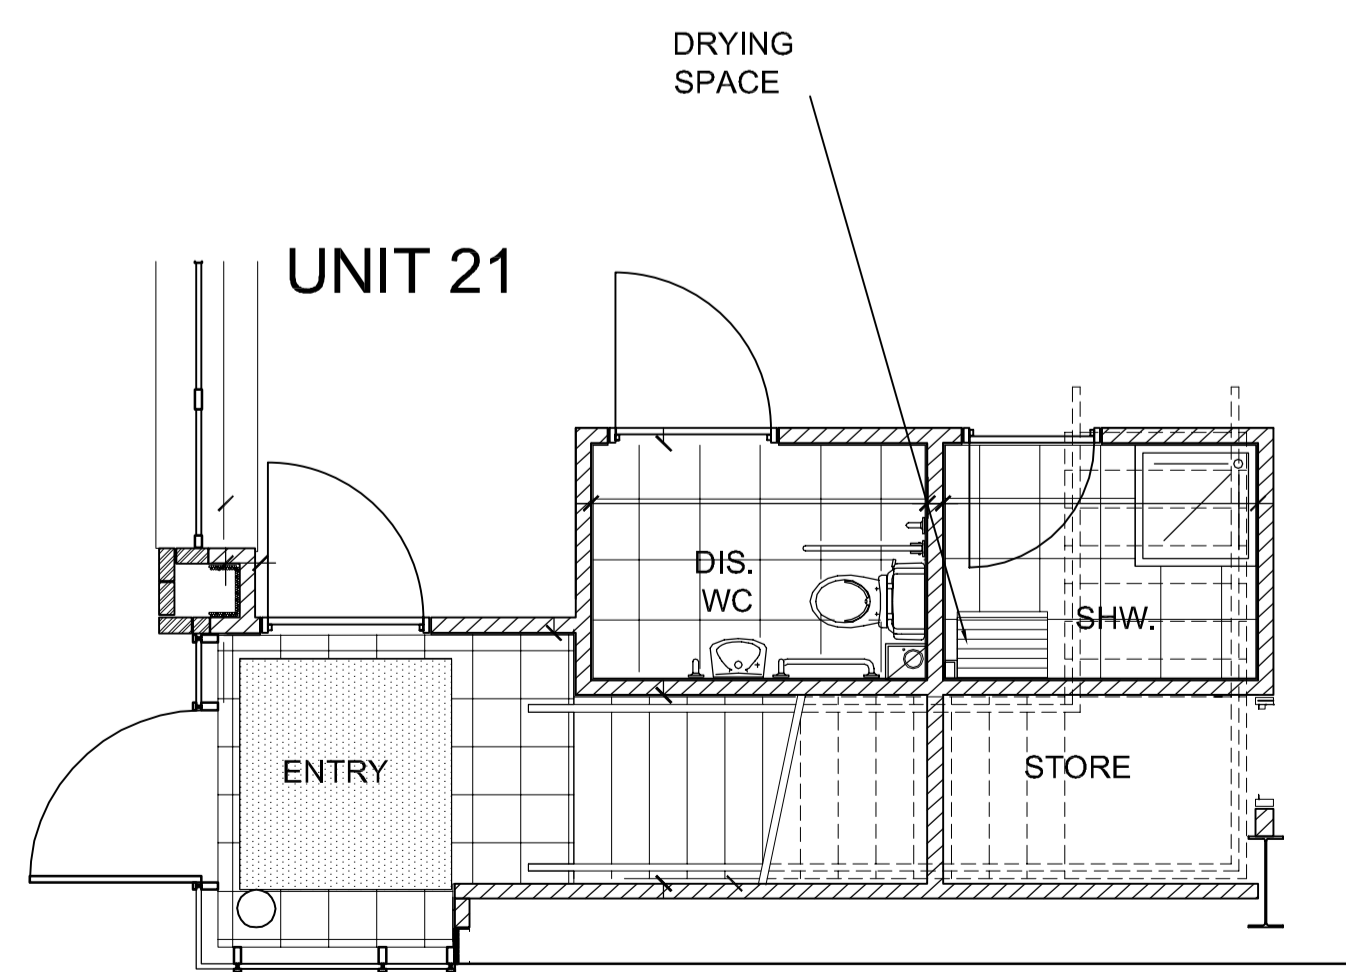


11 UNIT 21 - GF CORE PLAN
1:50

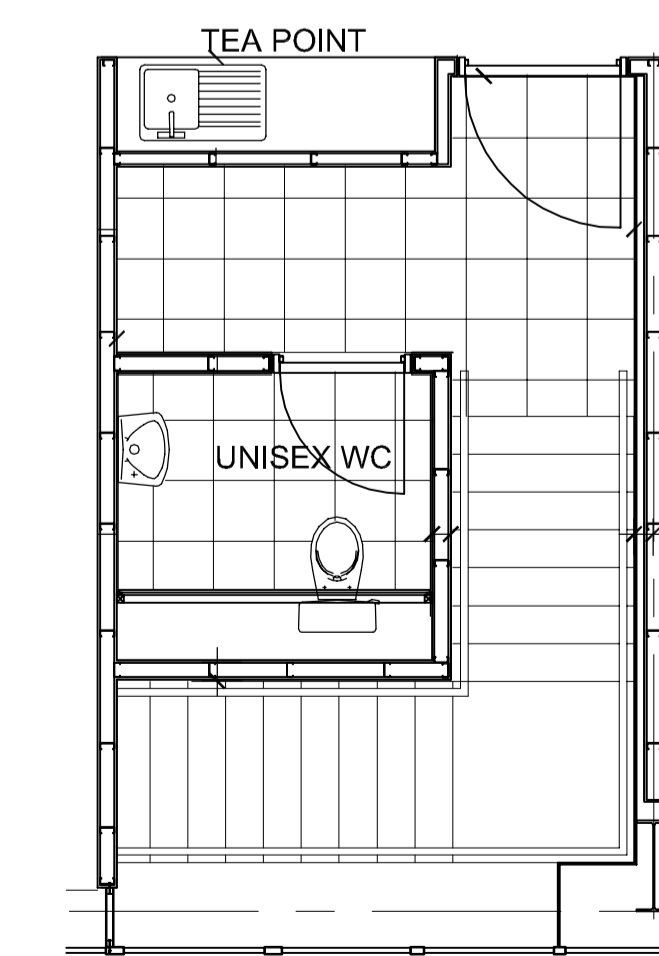

12 UNIT 21 - FF CORE PLAN
1:50

NOTES:
COPYRIGHT SUBJECT TO STATUTORY CONSENTS
COPYRIGHT RESERVED
DO NOT SCALE THIS DRAWING
BASED ON OS MAP REPRODUCED BY PERMISSION OF
CONTROLLER OF HM STATIONARY OFFICE (C) CROWN

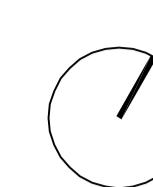

DO NOT USE ELECTRONIC VERSIONS OF THIS DRAWING TO
DETERMINE DIMENSIONS UNLESS SPECIFICALLY
AUTHORISED BY MICHAEL SPARKS ASSOCIATES

IF USING AN ELECTRONIC VERSION OF THIS DRAWING
FIGURED DIMENSIONS TAKE PRECEDENCE AND NOTIFY
MICHAEL SPARKS ASSOCIATES OF ANY DISCREPANCIES

ENSURE SEALING OF ALL JUNCTIONS TO COMPLY WITH PART L.

U-Values
Roof: 0.25
Floors: 0.25
Walls: 0.35
Glazing: 1.50

NOTE:
ROOF AND WALL CLADDING TO BE DESIGNED BY SPECIALIST
CONTRACTOR.
GLAZING DETAILS TO BE READ IN CONJUNCTION WITH THE
SPECIFICATION AND ALL RELEVANT BRITISH STANDARDS.
INCLUDE VAPOUR BARRIER TAPE AROUND ALL OPENINGS AND
JUNCTIONS.


ALL DIMENSIONS TO BE CHECKED ON SITE.
STEEL COLUMN SIZES TO BE CONFIRMED AND TOLERANCES TO BE AGREED.

NOTE:
MOISTURE RESISTANT PLASTERBOARD TO BE
USED THROUGHOUT WCs

AS BUILT

THIS "AS-BUILT" DRAWING IS BASED ON INFORMATION
SUPPLIED TO MICHAEL SPARKS ASSOCIATES BY MC LAREN
CONSTRUCTION AND INCORPORATES INSTRUCTIONS AND
OTHER DESIGN INFORMATION GIVEN TO MC LAREN
CONSTRUCTION DIRECTLY BY OTHERS

A	30.03.2009	Refer to sub-contractors drawings for specialist details This supercedes drawing no: 2716/EL/277 rev.J	JH	NSC
REV	DATE	NOTE	DRAW	CHK

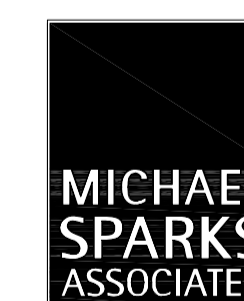

FROGMORE

CHARTERED ARCHITECTS
11 PLATO PLACE
ST DIONIS ROAD
LONDON SW6 4TU
TELEPHONE 020 7736 6162
FAX 020 7736 3898
www.msa-architects.co.uk

TITLE
CROSSWAYS, DARTFORD
DRAWING
SCHOONER PARK UNITS 16-21
CORE PLANS
CLIENT
FROGMORE

DATE	SCALE	DRAWN
MARCH 2009	1:50 @ A1	JH
	STATUS	CHECKED
	AS BUILT	NSC

DRAWING NUMBER
2716 / AB / 1229 A

