

NOTES:

SUBJECT TO STATUTORY CONSENTS
SUBJECT TO SURVEY

BASED ON OS MAP REPRODUCED BY PERMISSION OF
CONTROLLER OF HM STATIONARY OFFICE (c) CROWN
COPYRIGHT

COPYRIGHT RESERVED

DO NOT SCALE THIS DRAWING

DO NOT USE ELECTRONIC VERSIONS OF THIS DRAWING TO
DETERMINE DIMENSIONS UNLESS SPECIFICALLY
AUTHORISED BY MICHAEL SPARKS ASSOCIATES

IF USING AN ELECTRONIC VERSION OF THIS DRAWING,
FIGURED DIMENSIONS TAKE PRECEDENCE AND NOTIFY
MICHAEL SPARKS ASSOCIATES OF ANY DISCREPANCIES

NOTE:


PROVIDE ONE HOUR FIRE PROTECTION TO
UPPER FLOORS CONSTRUCTION AND ONE
HOUR FIRE PROTECTION TO SUPPORTING
STRUCTURE.

COMPLY WITH ALL PARTS OF APPROVED
DOCUMENTS IN PARTICULAR PART B, PART L2
AND PART M.


ENSURE SEALING OF ALL JUNCTIONS TO COMPLY WITH PART L.

NOTE:
ROOF AND WALL CLADDING TO BE DESIGNED BY SPECIALIST
CONTRACTOR.
CLADDING DETAILS TO BE READ IN CONJUNCTION WITH THE
SPECIFICATION AND ALL RELEVANT BRITISH STANDARDS.
INCLUDE VAPOUR BARRIER TAPE AROUND ALL OPENINGS AND
JUNCTIONS.

ALL DIMENSIONS TO BE CHECKED ON SITE.
STEEL COLUMN SIZES TO BE CONFIRMED AND TOLERANCES TO BE AGREED.

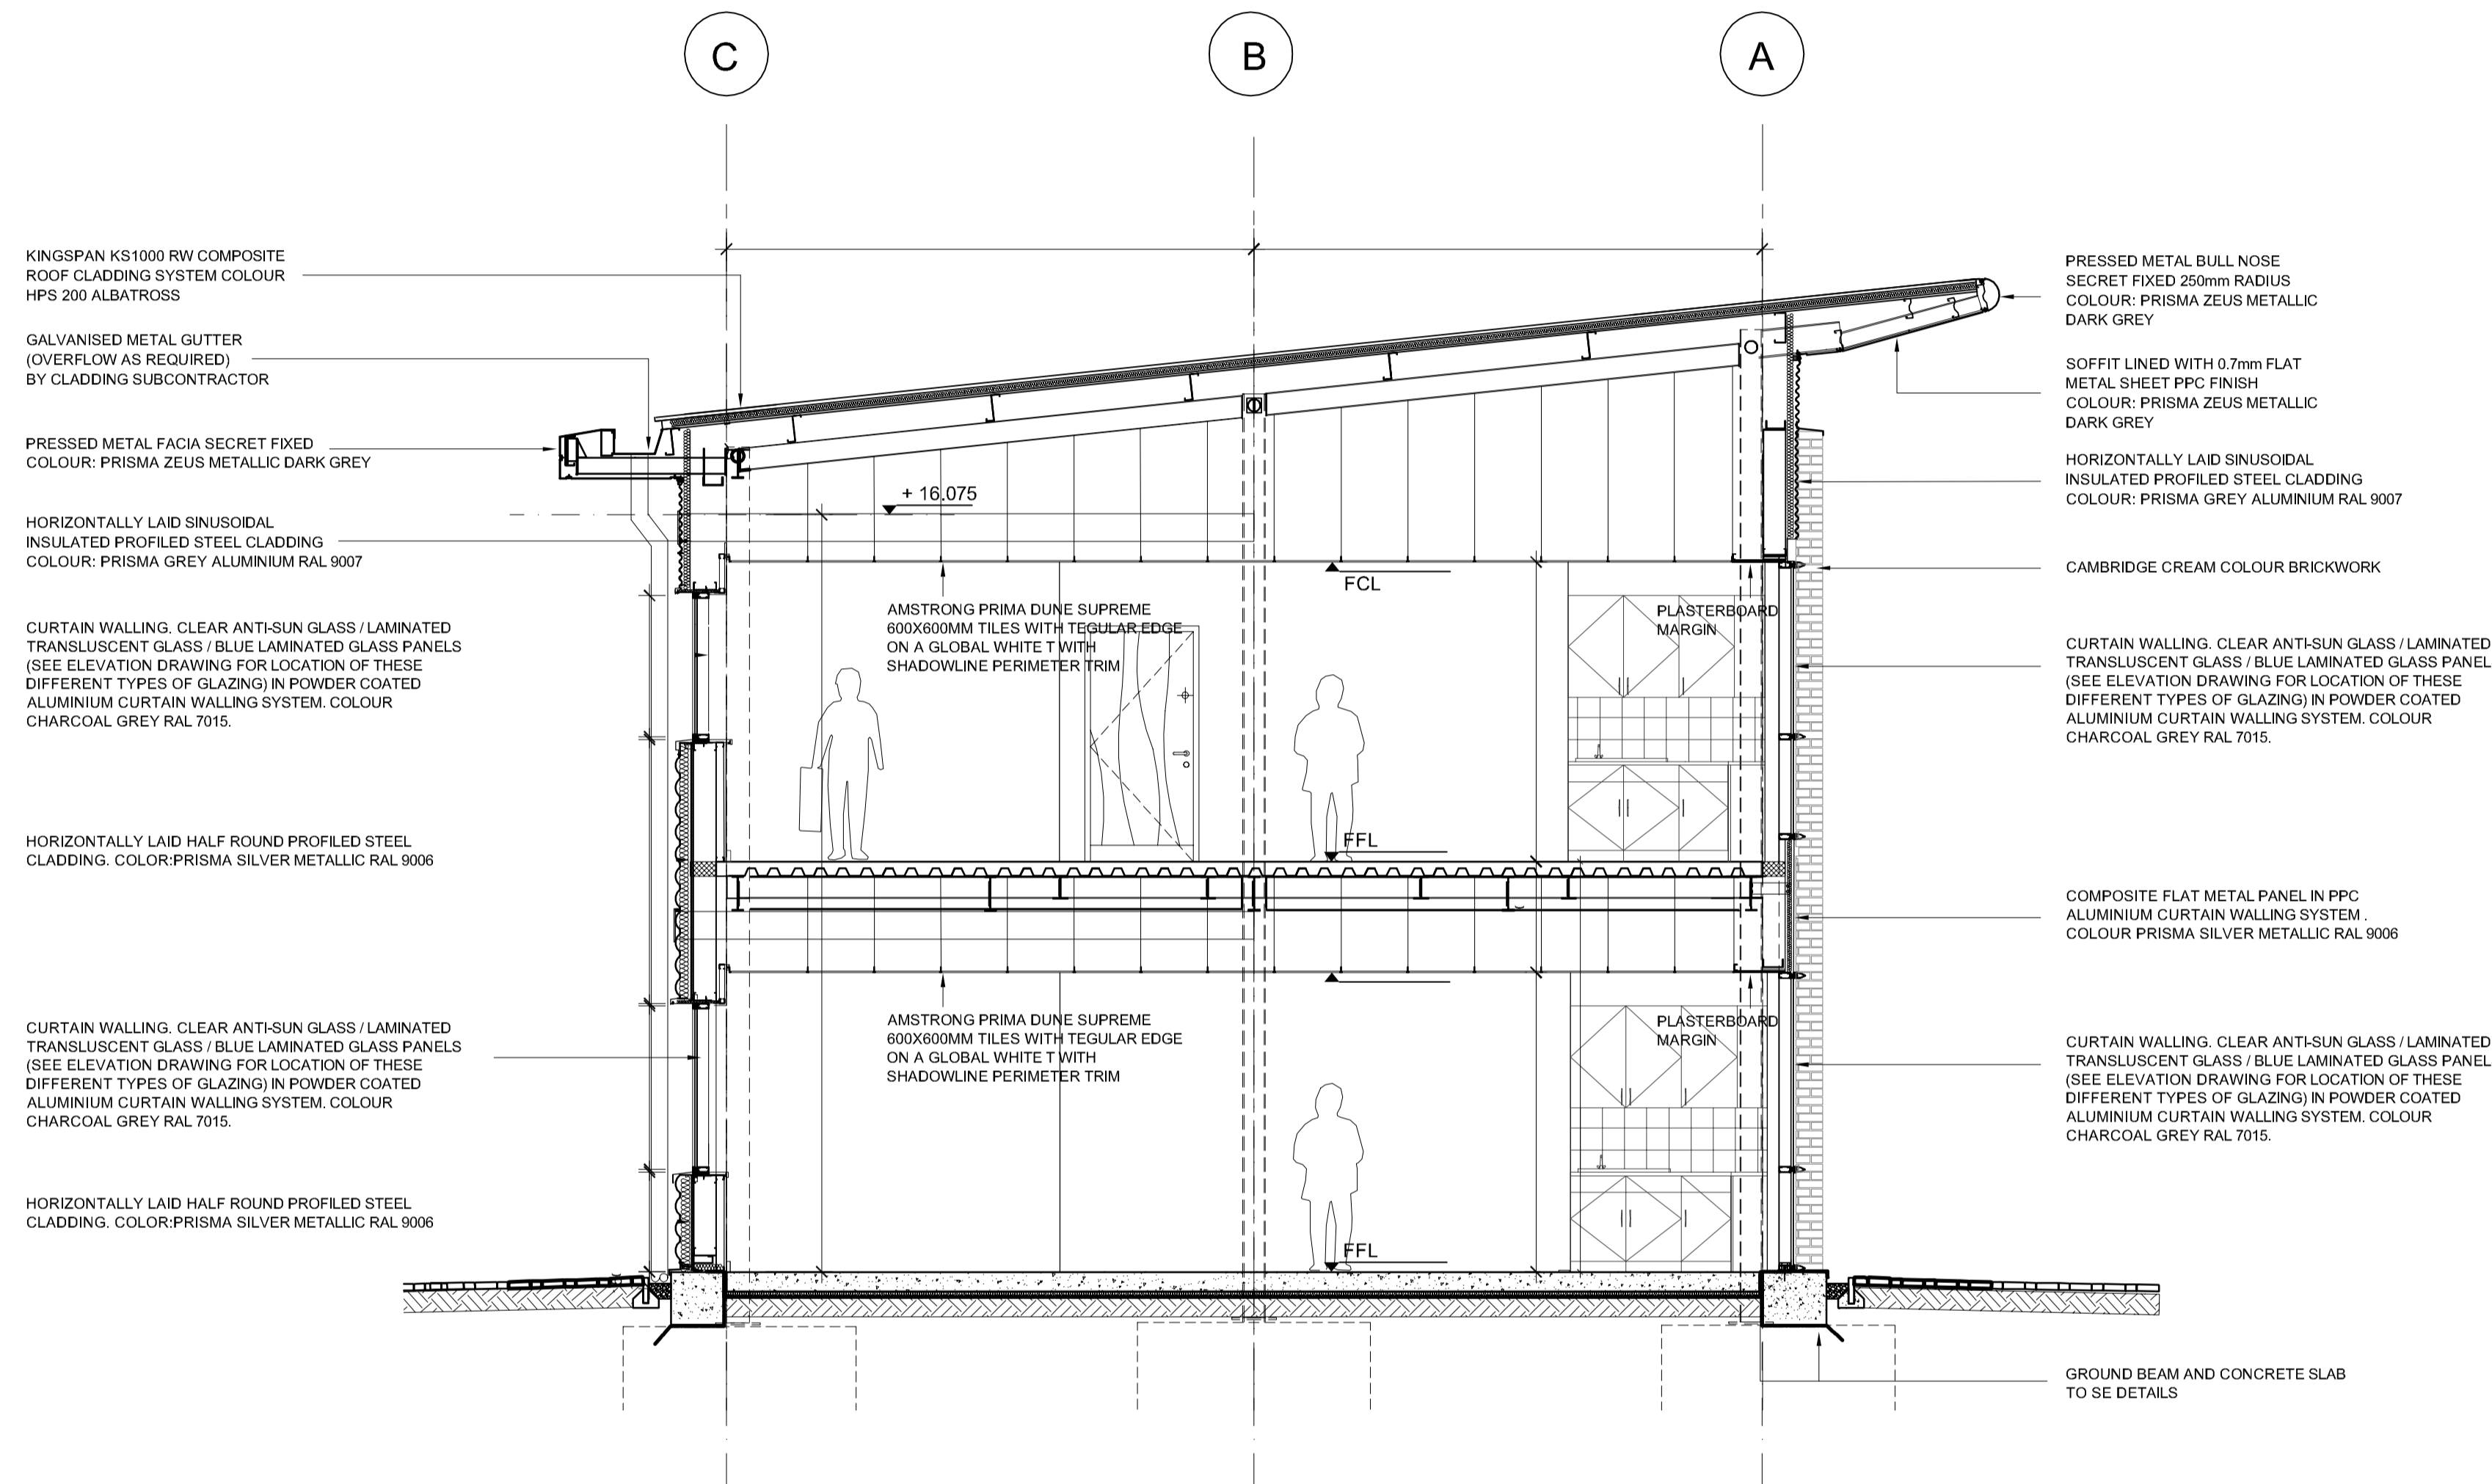

01 WATERSIDE OFFICE 4-8 - SECTION A-A
1112 1:50

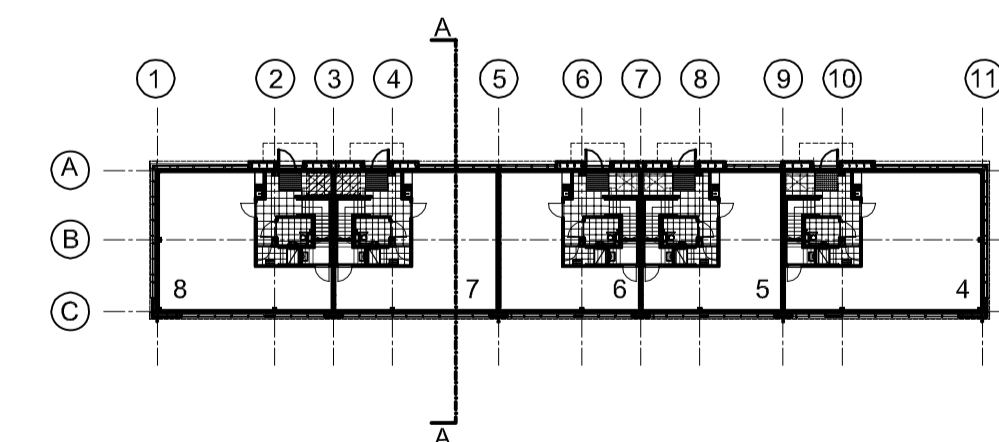


02 OFFICE 4-8 REFERENCE PLAN
1112 1:500

AS BUILT

THIS "AS-BUILT" DRAWING IS BASED ON INFORMATION
SUPPLIED TO MICHAEL SPARKS ASSOCIATES BY MC LAREN
CONSTRUCTION AND INCORPORATES INSTRUCTIONS AND
OTHER DESIGN INFORMATION GIVEN TO MC LAREN
CONSTRUCTION DIRECTLY BY OTHERS

REV	DATE	NOTE	DRAW	CHK
A	25.03.2009	Refer to sub-contractors drawings for specialist details This supercedes drawing no: 2716/RE/363 rev.F	JH	NSC

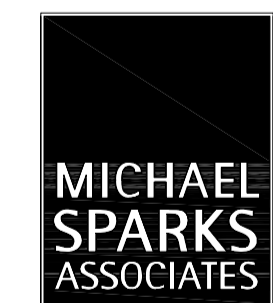

CHARTERED ARCHITECTS

11 PLATO PLACE
ST. BONS ROAD
LONDON SW6 4TU

TELEPHONE 020 7736 6162
FAX 020 7736 3896
www.msa-architects.co.uk

FROGMORE

TITLE
CROSSWAYS, DARTFORD

DRAWING
WATERSIDE COURT OFFICE 4-8
SECTIONS

CLIENT
FROGMORE

DATE
MARCH 2009

SCALE
1:50 @ A1

DRAWN
JH

STATUS
AS BUILT

CHECKED
NSC

DRAWING NUMBER
2716 / AB / 1112A